

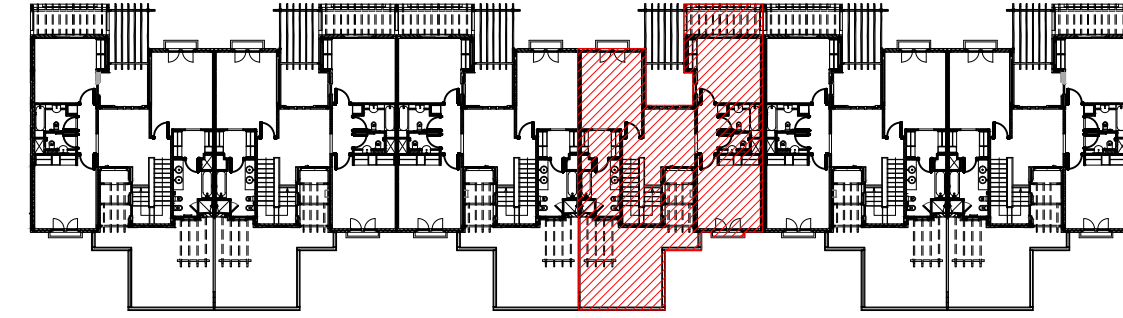


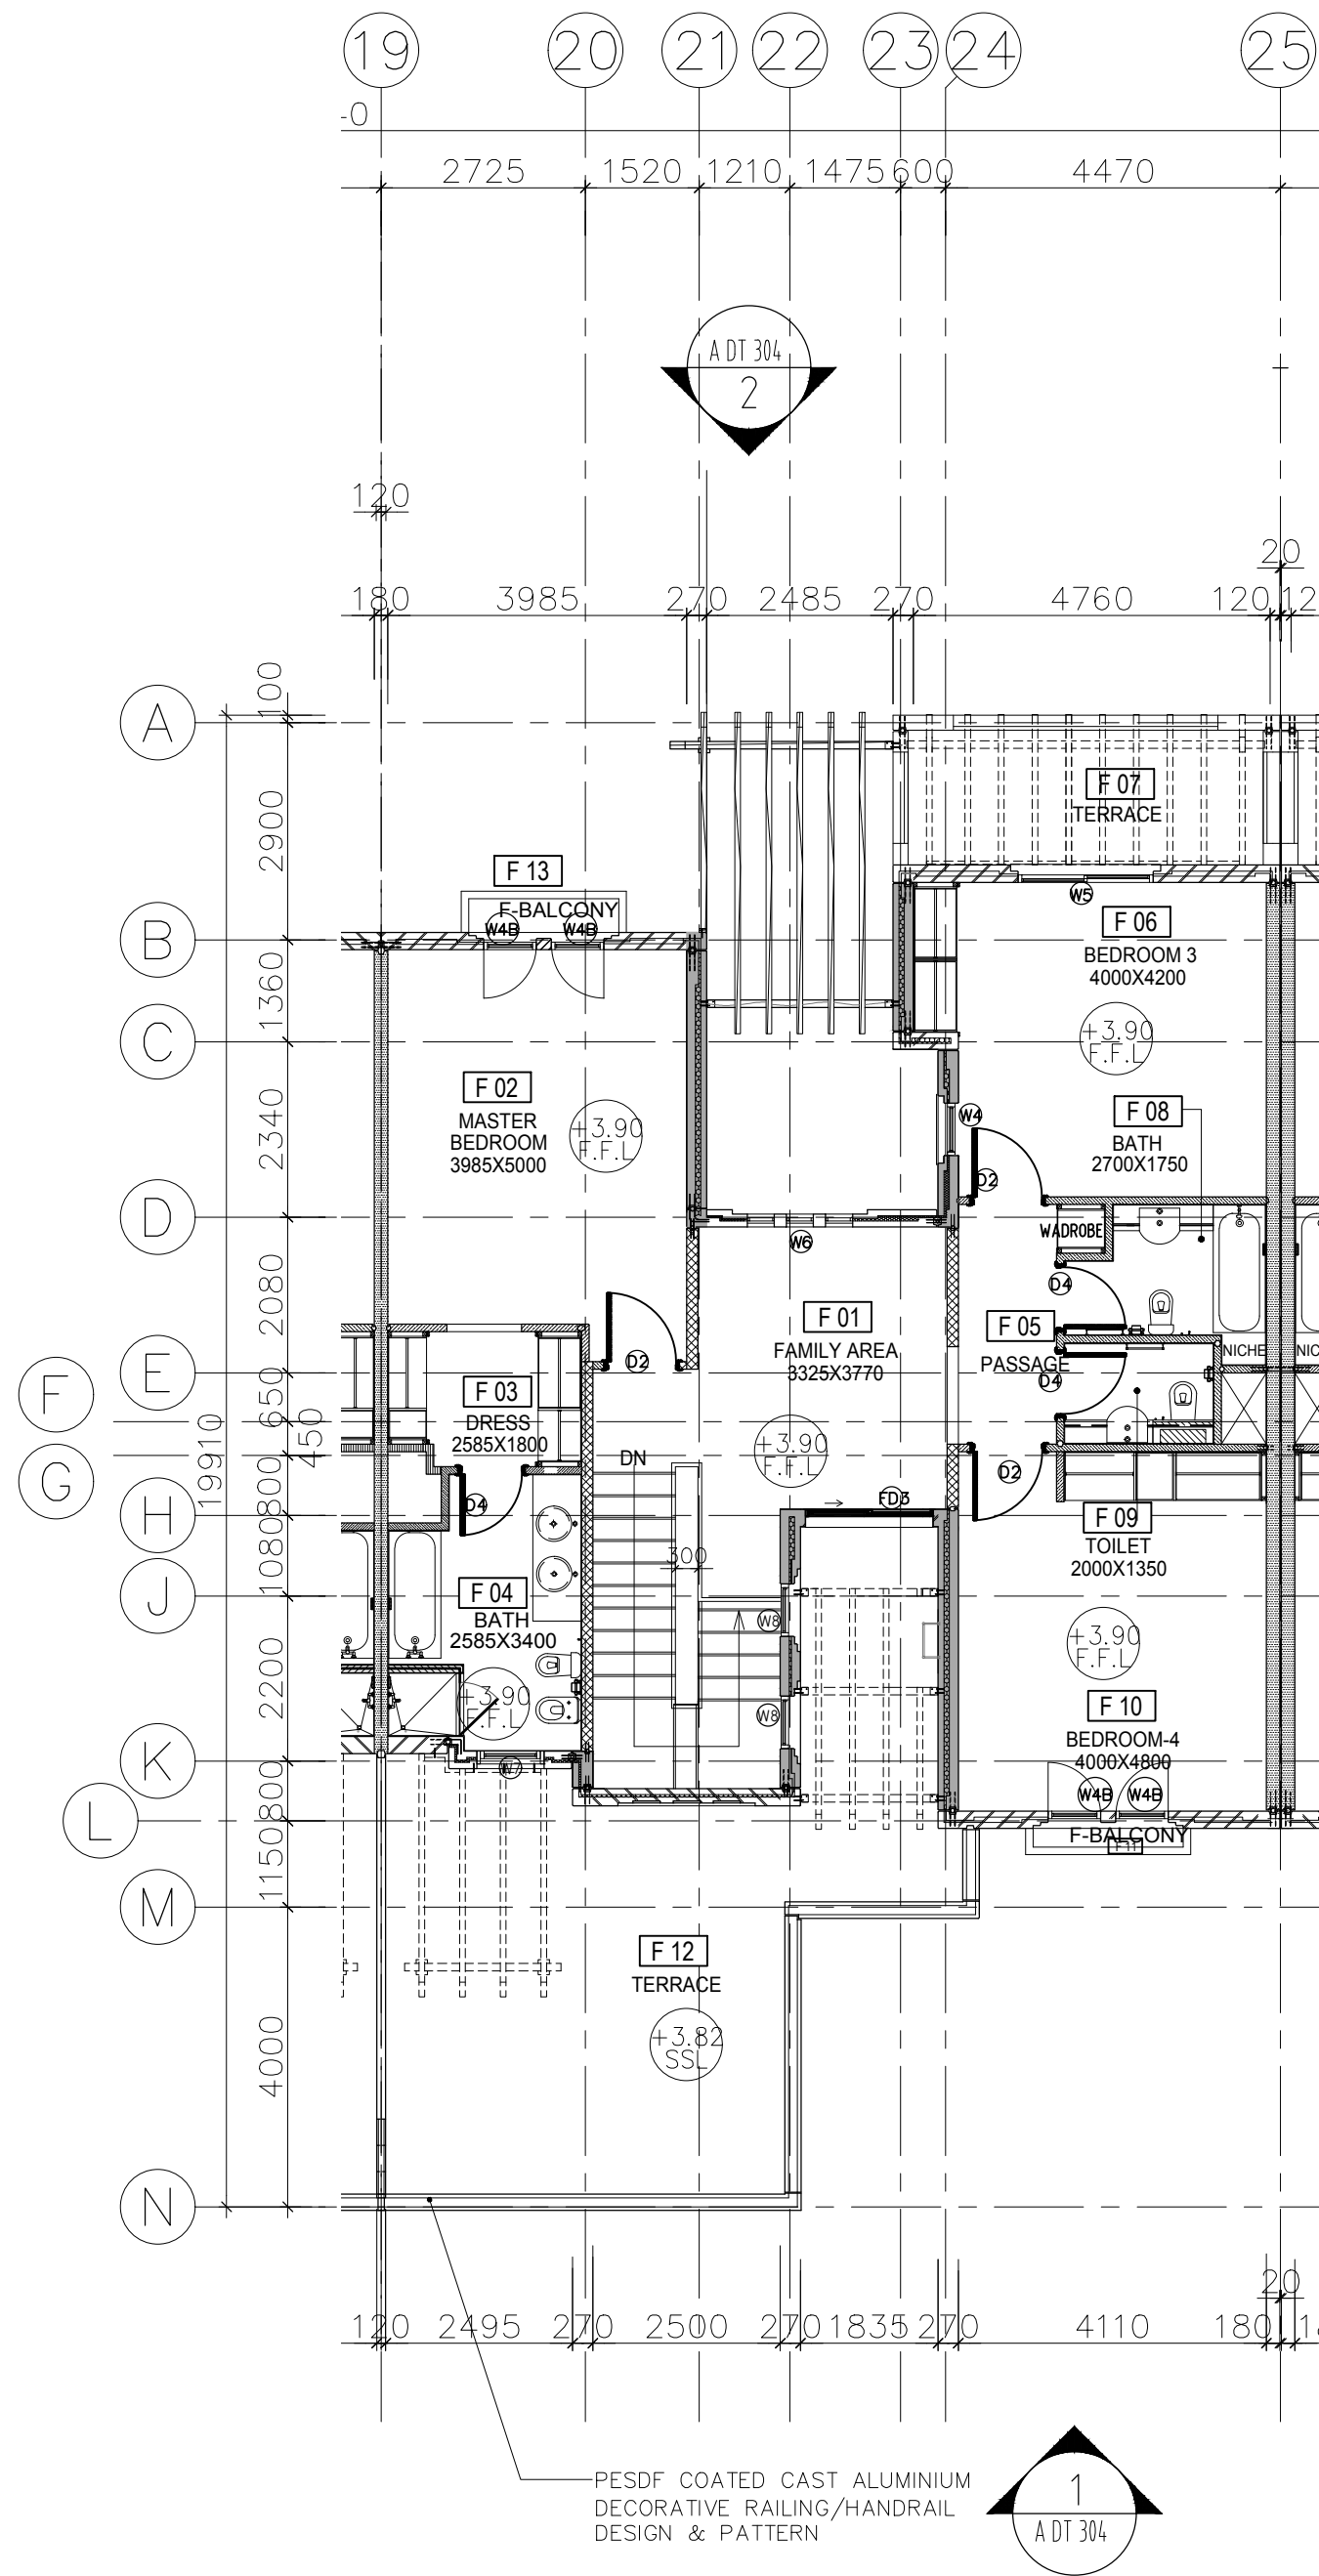

MU.F02.094

1 FIRST FLOOR PLAN
A DT 302 1:100

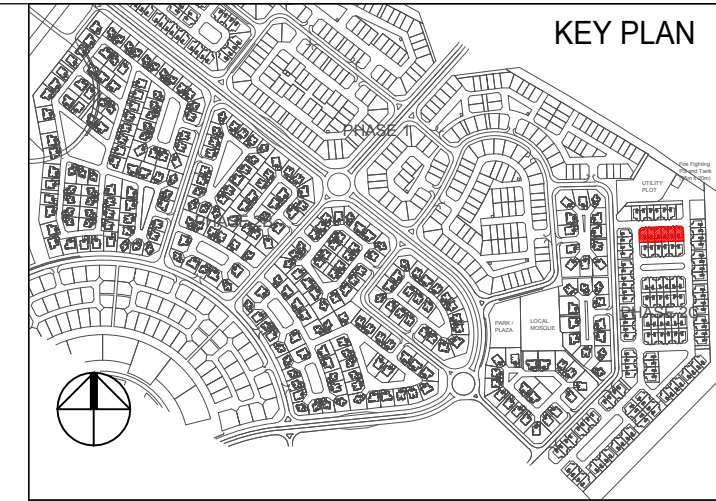

REV.	Date	Initials	Description
no	REVISIONS / ISSUE		
THIS DRAWING MUST NOT BE REPRODUCED IN WHOLE OR IN PART WITHOUT THE PRIOR APPROVAL OF ARIF & BINTOAK			
Project			
 MUDON			
Client			
 DUBAI PROPERTIES			
Lead Consultant & Architects			
 Arif&Bintoak consulting architects & engineers POST BOX 3670 DUBAI, UAE TEL 04-3372888 FAX 04-3370352 -arfoak@emirates.net.ae			
Main Contractor			
 Shapoorji Pallonji Mideast (L.L.C) P.O BOX: 118219, DUBAI, UAE. TEL: 04-2690335, http://www.shapoorji.com			
AS BUILT			
Project Title:			
MUDON PHASE II (120 TOWN HOUSES) ON PLOT NO # 676 -1061 AT AL RUWAYYAH, DUBAI.			
Drawing Title:			
MU.F02.094 (6 - CLUSTER VILLAS) FIRST FLOOR PLAN			
Scale(s): 1:100 @ A2	Date Drawn: 20-09-2016	Project no: 1353B	
Drawn by: dcp	Checked by: SN	Drawing no: SPML/MDN/A DT 302	Revision AB00
Cad File ref. 1353B A DT 302	Approved by: SN		